



MORGAN CIVIL ENGINEERING, INC.

PO Box 358, Manzanita, OR 97130

ph: 503-801-6016

www.morgancivil.com

August 9, 2022

Riverview Meadows Development, LLC

Alex Reverman

areverman@gmail.com

**RE: Water System Improvements for Tax Lot 3600, Map 03N 10W 23B, Nehalem, Tillamook County, Oregon (Riverview Meadows, Phase 2)
Project #19-10-Riv**

Dear Mr. Reverman:

At your request, I have prepared a preliminary design for the water distribution system to be serving the proposed subdivision of Riverview Meadows Phase 2.

Storage

We propose to install a new storage tank at the northwestern corner of the new development, with a ground elevation of about 160 feet. The City tank is at an elevation of 220 feet, so the new tank can be fed by gravity.

The proposed tank will include 60,000 gallons of water storage for fire-fighting (1000 gpm for 60 minutes) and about 20,000 for domestic use (240 gallons per house for 90 homes). The average City residential usage is 141 gallons per day. The total tank size will be about 80,000 gallons.

The new tank will be filled with treated water from the City System, with a dedicated feed line beginning near Lot 13. The feeding pipe will be in a shared trench with a new distribution pipe. A pressure reducing valve (PRV) will need to be installed at the tank in order to prevent overflowing.

The feeder line, tank, and PRV are shown on the attached drawing in red.

RIVERVIEW MEADOWS DEVELOPMENT
Water System Improvements
Riverview Meadows Phase 2
Nehalem, Tillamook County, Oregon

August 8, 2022,

MORGAN CIVIL ENGINEERING, INC.

Distribution

Water from the new reservoir will be pumped to a pressure of about 60 psi (140 ft gauge pressure/300 feet total pressure). The water will then be distributed in a looped system in order to serve the residents of Phase 2 and Phase 1 of the subdivision (not including Lots 1-2, and 12-13).

Lot 75 is located at elevation 155 feet. Lot 14 is at elevation of 120 feet. Therefore, the service pressure will be between roughly 60 psi and 85 psi.

Connection


In the roadway near Lot 14, a second PRV will be used in order to connect to the City system. The pressurized system will tie into the city system in order to allow flow when needed. This PRV is shown in red on the drawing.

There is a gap in the map in order to show both ends of the new system. Further design of these improvements will be necessary before construction.

If you have any questions, please contact me at jason@morgancivil.com or 503-801-6016.

Sincerely,

MORGAN CIVIL ENGINEERING, INC.

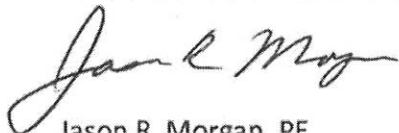


Jason R. Morgan, PE
Professional Engineer



cc: Project File #19-10-Riv

<V:\19-10-Riv\Reports\Riverview Meadows-2 Water System.docx>

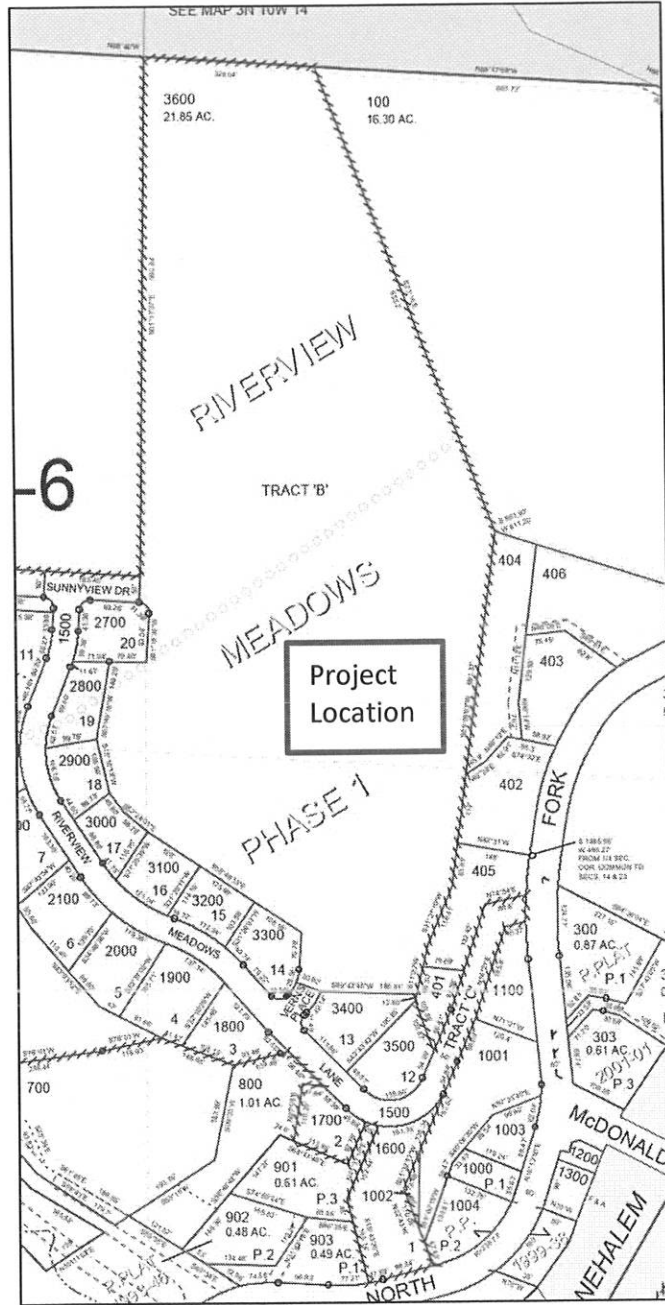

**Tax Lot 3600, Map 3N 10W 23B
RIVERVIEW MEADOWS PHASE 2
Nehalem, Tillamook County Oregon**



MORGAN CIVIL ENGINEERING, INC.
 CIVIL ENGINEERING
 INSPECTION
 PLANNING
 30 BOX 538
 MANAYUNK, PA 19340
 WWW.MORGANCI.COM
 (610) 801-6916
 MAY 12, 2022




RIVERVIEW MEADOWS DEVELOPMENT, LLC
UTILITY LAYOUT

SHEET
3b
of TWENTY

LEGEND:

EXISTING	
	PROPERTY LINE
	SEWER LINE
	MANHOLE
	WATER LINE
	ROAD
	EASEMENT
	GATE VALVE
PROPOSED	
	PROPERTY LINE
	EASEMENT
	SEWER MAIN
	SEWER MANHOLE/CO
	SEWER SERVICE
	WATER MAIN
	WATER FEEDER LINE
	WATER VALVE
	FIRE HYDRANT
	WATER SERVICE
	EDGE OF SHOULDER
	EDGE OF ASPHALT

NO.	DATE	DESCRIPTION
1	07/24/2022	ADD WATER FEEDER, TANK, PUMP PYS

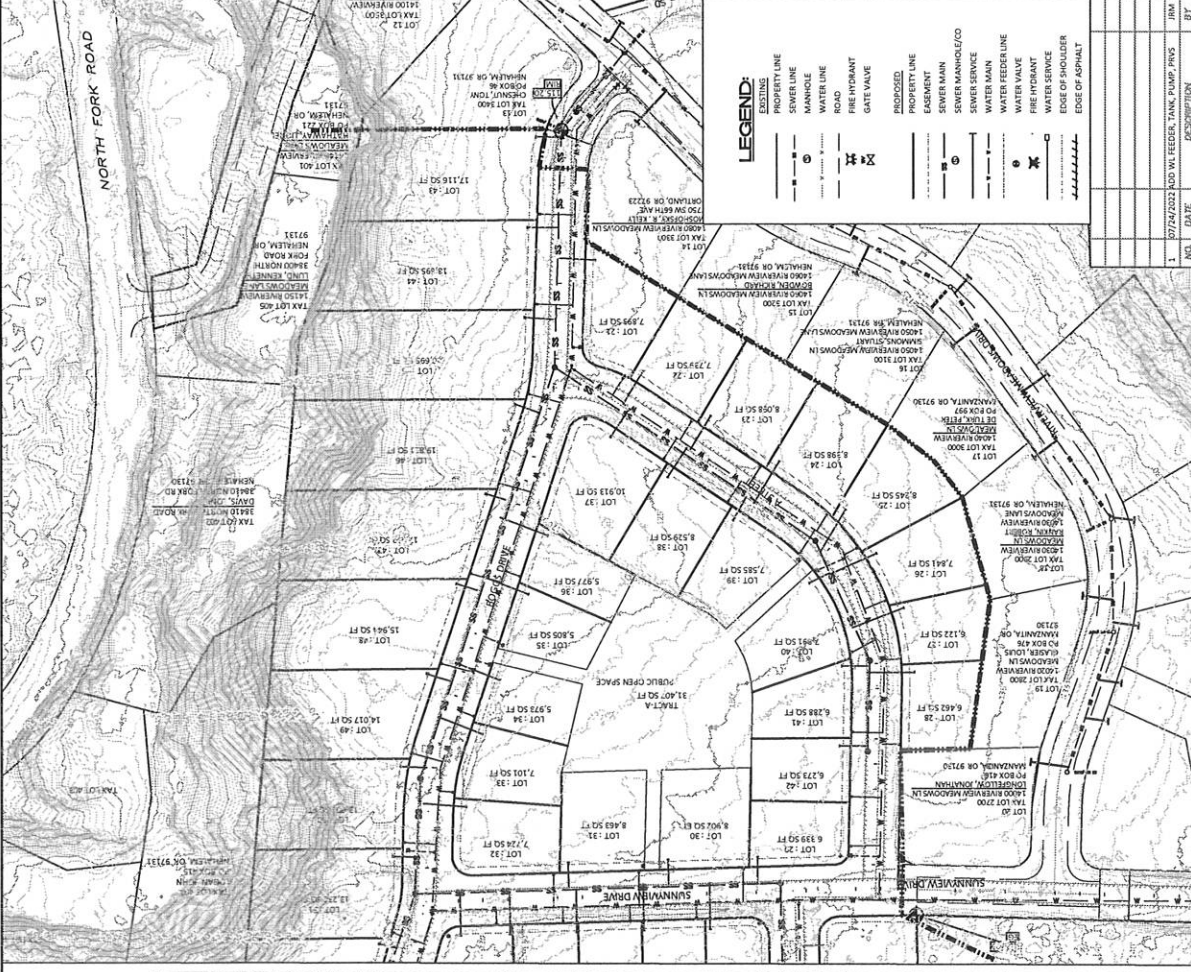

- ELEVATIONS:**
- CITY TANK - 220 FT
 - PROPOSED TANK - 160 FT
 - LOT 74 - 155 FT
 - LOT 3 - 120 FT
- USE PUMP AT "P" OFF EQ
 (ADD 160 FEET = 60 PSI)

- WATERLINE:**
1. INSTALL NEW TEE ON MAINLINE AT LOT 14.
 2. INSTALL FEEDER PIPE TO TANK SITE. L=1200 FT.
 3. INSTALL PRESSURE REDUCING VALVE.
 4. STORE WATER IN TANK. MIN 80,000-GALLON.
 5. DISCHARGE THROUGH PUMP STATION. ADD 160 PSI.
 6. AT LOT 14, INSTALL PVT TO REDUCE TO CITY PRESSURE.

RIVERVIEW MEADOWS
PHASE 2
74 LOT SUBDIVISION
TENTATIVE PLAN
 MAP 5N 60W SECTION 28B

GRAPHIC SCALE

1 inch = 60 ft.